



6420 Congress Ave  
Boca Raton, FL 33487

Phone: (561) 544-4976  
Email:  
Mereida.Bowens@crowncastle.com  
www.crowncastle.com

March 19, 2020

VIA email [angel@hallrosenberg.com](mailto:angel@hallrosenberg.com)

CITY OF LAUDERHILL  
5581 WEST OAKLAND PARK BLVD  
ATTN: CITY MANAGER  
LAUDERHILL, FL 33313

Re: BU 812072 / "DXZW" / 5455 NW 19th St., Lauderhill, FL 33313 ("Site")  
Option and Lease Agreement, dated February 10, 2020, as amended ("Lease")  
Consent for modifications – Sprint Order # 510913

Dear CITY OF LAUDERHILL,

I am reaching out to you on behalf of New Cingular Wireless PCS LLC ("Lessee") in order to obtain your consent as may be required by the Lease.

In order to better serve the public and minimize the amount of towers in an area where this property is located, Sprint PCS intends to modify its equipment at the wireless communication facility (the "Modification").

Under the Lease, Landlord's consent cannot be unreasonably withheld, conditioned or delayed. Therefore, please provide your consent as soon as possible by signing below and returning one original to the address indicated above so that we may install Sprint PCS's equipment as permitted under the Lease.

Please see the enclosed supplemental materials, as may be required by the Lease. A prepaid envelope is included for your convenience. If you have any questions concerning this request, please contact Mereida Bowens at (561) 544-4976 or [Mereida.Bowens@crowncastle.com](mailto:Mereida.Bowens@crowncastle.com)

Sincerely,

Mereida Bowens  
Real Estate Specialist

Agreed and accepted \_\_\_\_\_

(Date)

\_\_\_\_\_  
(Lessor's signature)

CITY OF LAUDERHILL

March 19, 2020

Page 2

[Enclosures]

---

*P.S. Please indicate below if you are interested in learning more about removing the obligation for you to sign these consent letters and receive a notice letter instead.*

\_\_\_\_\_ *(check here) Yes, I'm interested in learning more.*





691 SPRINT PARKWAY  
OVERLAND PARK, KS 66211-2639



4511 N HINKES AVE, SUITE 210  
TAMPA, FL 33614

SPRINT PCS SITE NUMBER:  
MI60XC002

BU #: 812472  
DXZW

5455 NW 19TH ST.  
LAUDERHILL, FL 33313


EXISTING 125'-0" MONOPOLE

REV	DATE	DRWN	DISCREPTION	DES/QA
A	02/10/09	KB	PRELIMINARY	CSY

**THIS DOCUMENT IS  
PRELIMINARY IN  
NATURE AND IS NOT A  
FINAL, SIGNED AND  
SEALED DOCUMENT**

IT IS A VIOLATION OF LAW FOR ANY PERSON,  
UNLESS THEY ARE ACTING UNDER THE DIRECTION  
OF A LICENSED PROFESSIONAL ENGINEER,  
TO ALTER THIS DOCUMENT.


SHEET NUMBER: **C-1** REVISION: **A**

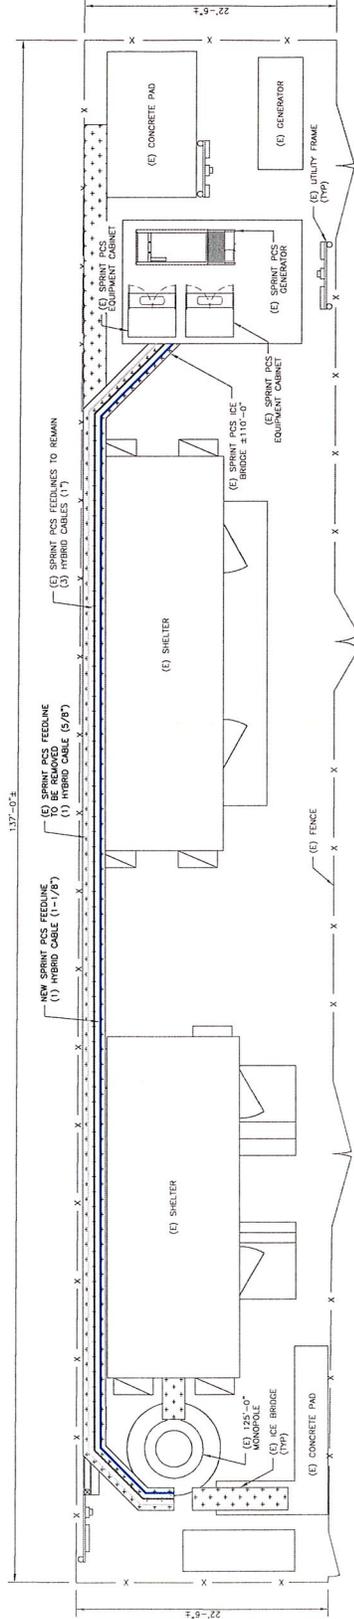

FINAL EQUIPMENT PLAN  
SCALE: 3/16"=1'-0" (PL. S&D)  
3/32"=1'-0" (1:32)



6391 SPRINT PARKWAY  
OVERLAND PARK, KS 66211-2650

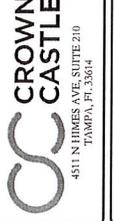

4511 N HIMES AVE, SUITE 210  
TAMPA, FL 33614

SPRINT PCS SITE NUMBER:  
MI60XC002  
BU #: 812072  
DXZW

5455 NW 19TH ST.  
LAUDERHILL, FL 33313


EXISTING 125'-0" MONOPOLE

REV	DATE	BY	DESCRIPTION	DESIGN
A	02/02/08	MB	PRELIMINARY	CSB


**THIS DOCUMENT IS  
PRELIMINARY IN  
NATURE AND IS NOT A  
FINAL, SIGNED AND  
SEALED DOCUMENT**

IT IS A VIOLATION OF LAW FOR ANY PERSON,  
UNLESS THEY ARE ACTING UNDER THE DIRECTION  
OF A LICENSED PROFESSIONAL ENGINEER,  
TO ALTER THIS DOCUMENT.


SHEET NUMBER: **C-2**  
REVISION: **A**

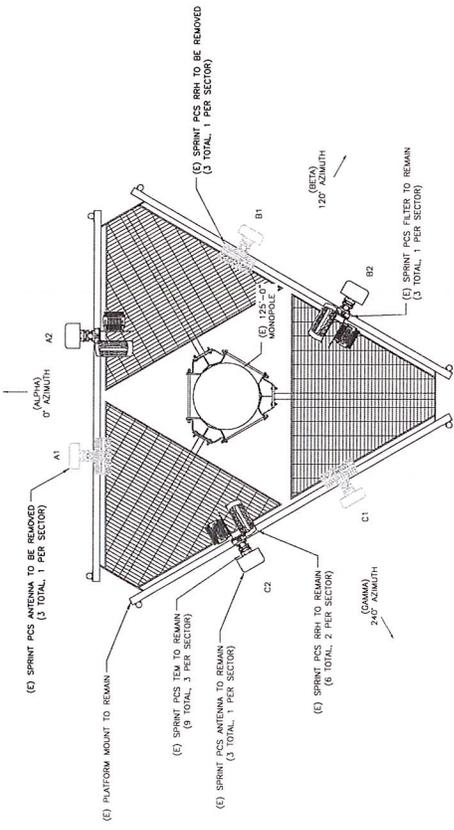

2 EXISTING ANTENNA PLAN  
SCALE: NOT TO SCALE

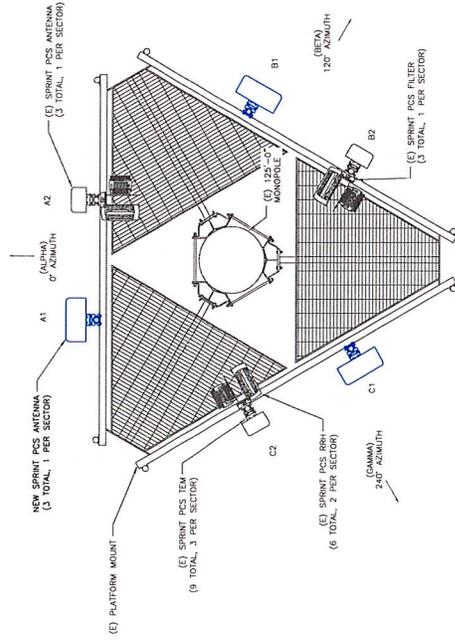

3 FINAL ANTENNA PLAN  
SCALE: NOT TO SCALE

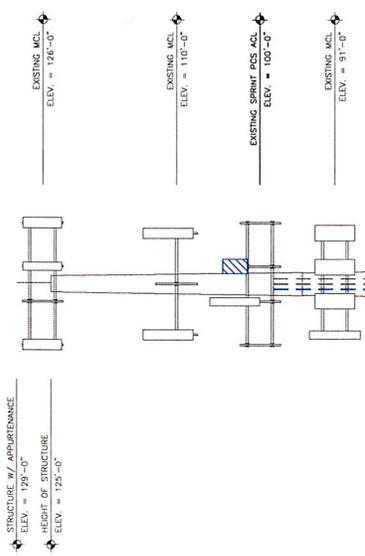

1 FINAL ELEVATION  
SCALE: NOT TO SCALE

**GENERAL NOTES:**  
1. THE ENGINEER HAS REVIEWED THESE DRAWINGS AND  
THEY ARE ACCURATE TO THE BEST OF HIS KNOWLEDGE  
AND BELIEF. THIS DOCUMENT IS NOT TO BE USED FOR  
CONSTRUCTION WITHOUT THE ENGINEER'S SIGNATURE  
AND SEAL.  
2. CORRESPONDING PILING MOUNT ANALYSIS.  
CONTRACTOR SHALL REVIEW THE MOUNT  
ANALYSIS FOR ANY CONDITIONS PRIOR TO  
INSTALLATION.  
3. ANY REQUIRED MOUNT MODIFICATION DESIGN OR  
INSTALLATION REQUIREMENTS SHALL BE APPROVED BY  
EOR.