

Reviewed by:
Vanessa Bauman
Senior Designer
Wendy's Design Department 05/31/2024

This is a cursory review only. Completeness and correctness of documents is the responsibility of the Architect or Engineer of Record.




















1. Review comments / mark-ups and revise accordingly.
2. Review and include ALL applicable DESIGN BULLETINS (download from Information Gateway) and update the CD set if currently in production or in permitting phase.

PV	PAVERS
SCO	SEWER CLEANOUT
R	RAMP
SMH	SEWER MANHOLE
SMON	SIGN MONUMENT
TSB	TRAFFIC SIGNAL
TSMA	TRAFFIC SIGNAL
UP	UTILITY POLE
WM	WATER METER

SEE SHEET 2 OF 2 FOR CERTIFICATIONS,
LEGAL DESCRIPTION, SURVEYOR'S NOTES
AND SCHEDULE B-2 LOCATABLE
EXCEPTIONS

PARKING SPACE TABLE	
TOTAL:	274
REGULAR	264
HANDICAP	10

SYMBOLS:

- CLEANOUT
- CATCH BASIN
- ELECTRIC METER
- GATE VALVE
- HAND HOLE
- LIGHT POLE
- MONITORING WELL
- SEWER MANHOLE
- UTILITY MANHOLE
- WATER METER
- PROPANE GAS TANK
- DRAINAGE MANHOLE
- TELEPHONE BOX
- SIGNAL BOX
- WOOD POLE
- UTILITY POLE
- ANCHOR
- SIGN
- FIRE HYDRANT

Attachment "D"

VICINITY MAP
N.T.S.

Polas W. Blinow, PSM
Real Surveyor & Mapper FL LS 5989
 18724 SEA TURTLE LANE
 Boca Raton, Florida 33498
 Telephone No. (561) 441-5449

3


DATE:	REVISIONS:
-------	------------

TITLE: ALTA/ACSM LAND TITLE SURVEY
PORTION OF TRACT "A"
INVENTORY SHOPPING CENTER
(PLAT BOOK 77 PAGE 22 - BROWARD COUNTY, FLORIDA)
CITY OF LAUDERHILL, BROWARD COUNTY, FLORIDA

DRAWN BY: nb
APPROVED BY: BLINOW
DATE: 10/9/2013
SCALE: 1"=30'
DRAWING NO.:
SHOPPES-ALTA.10.9.2013

SHEET
NUMBER

1 OF 2

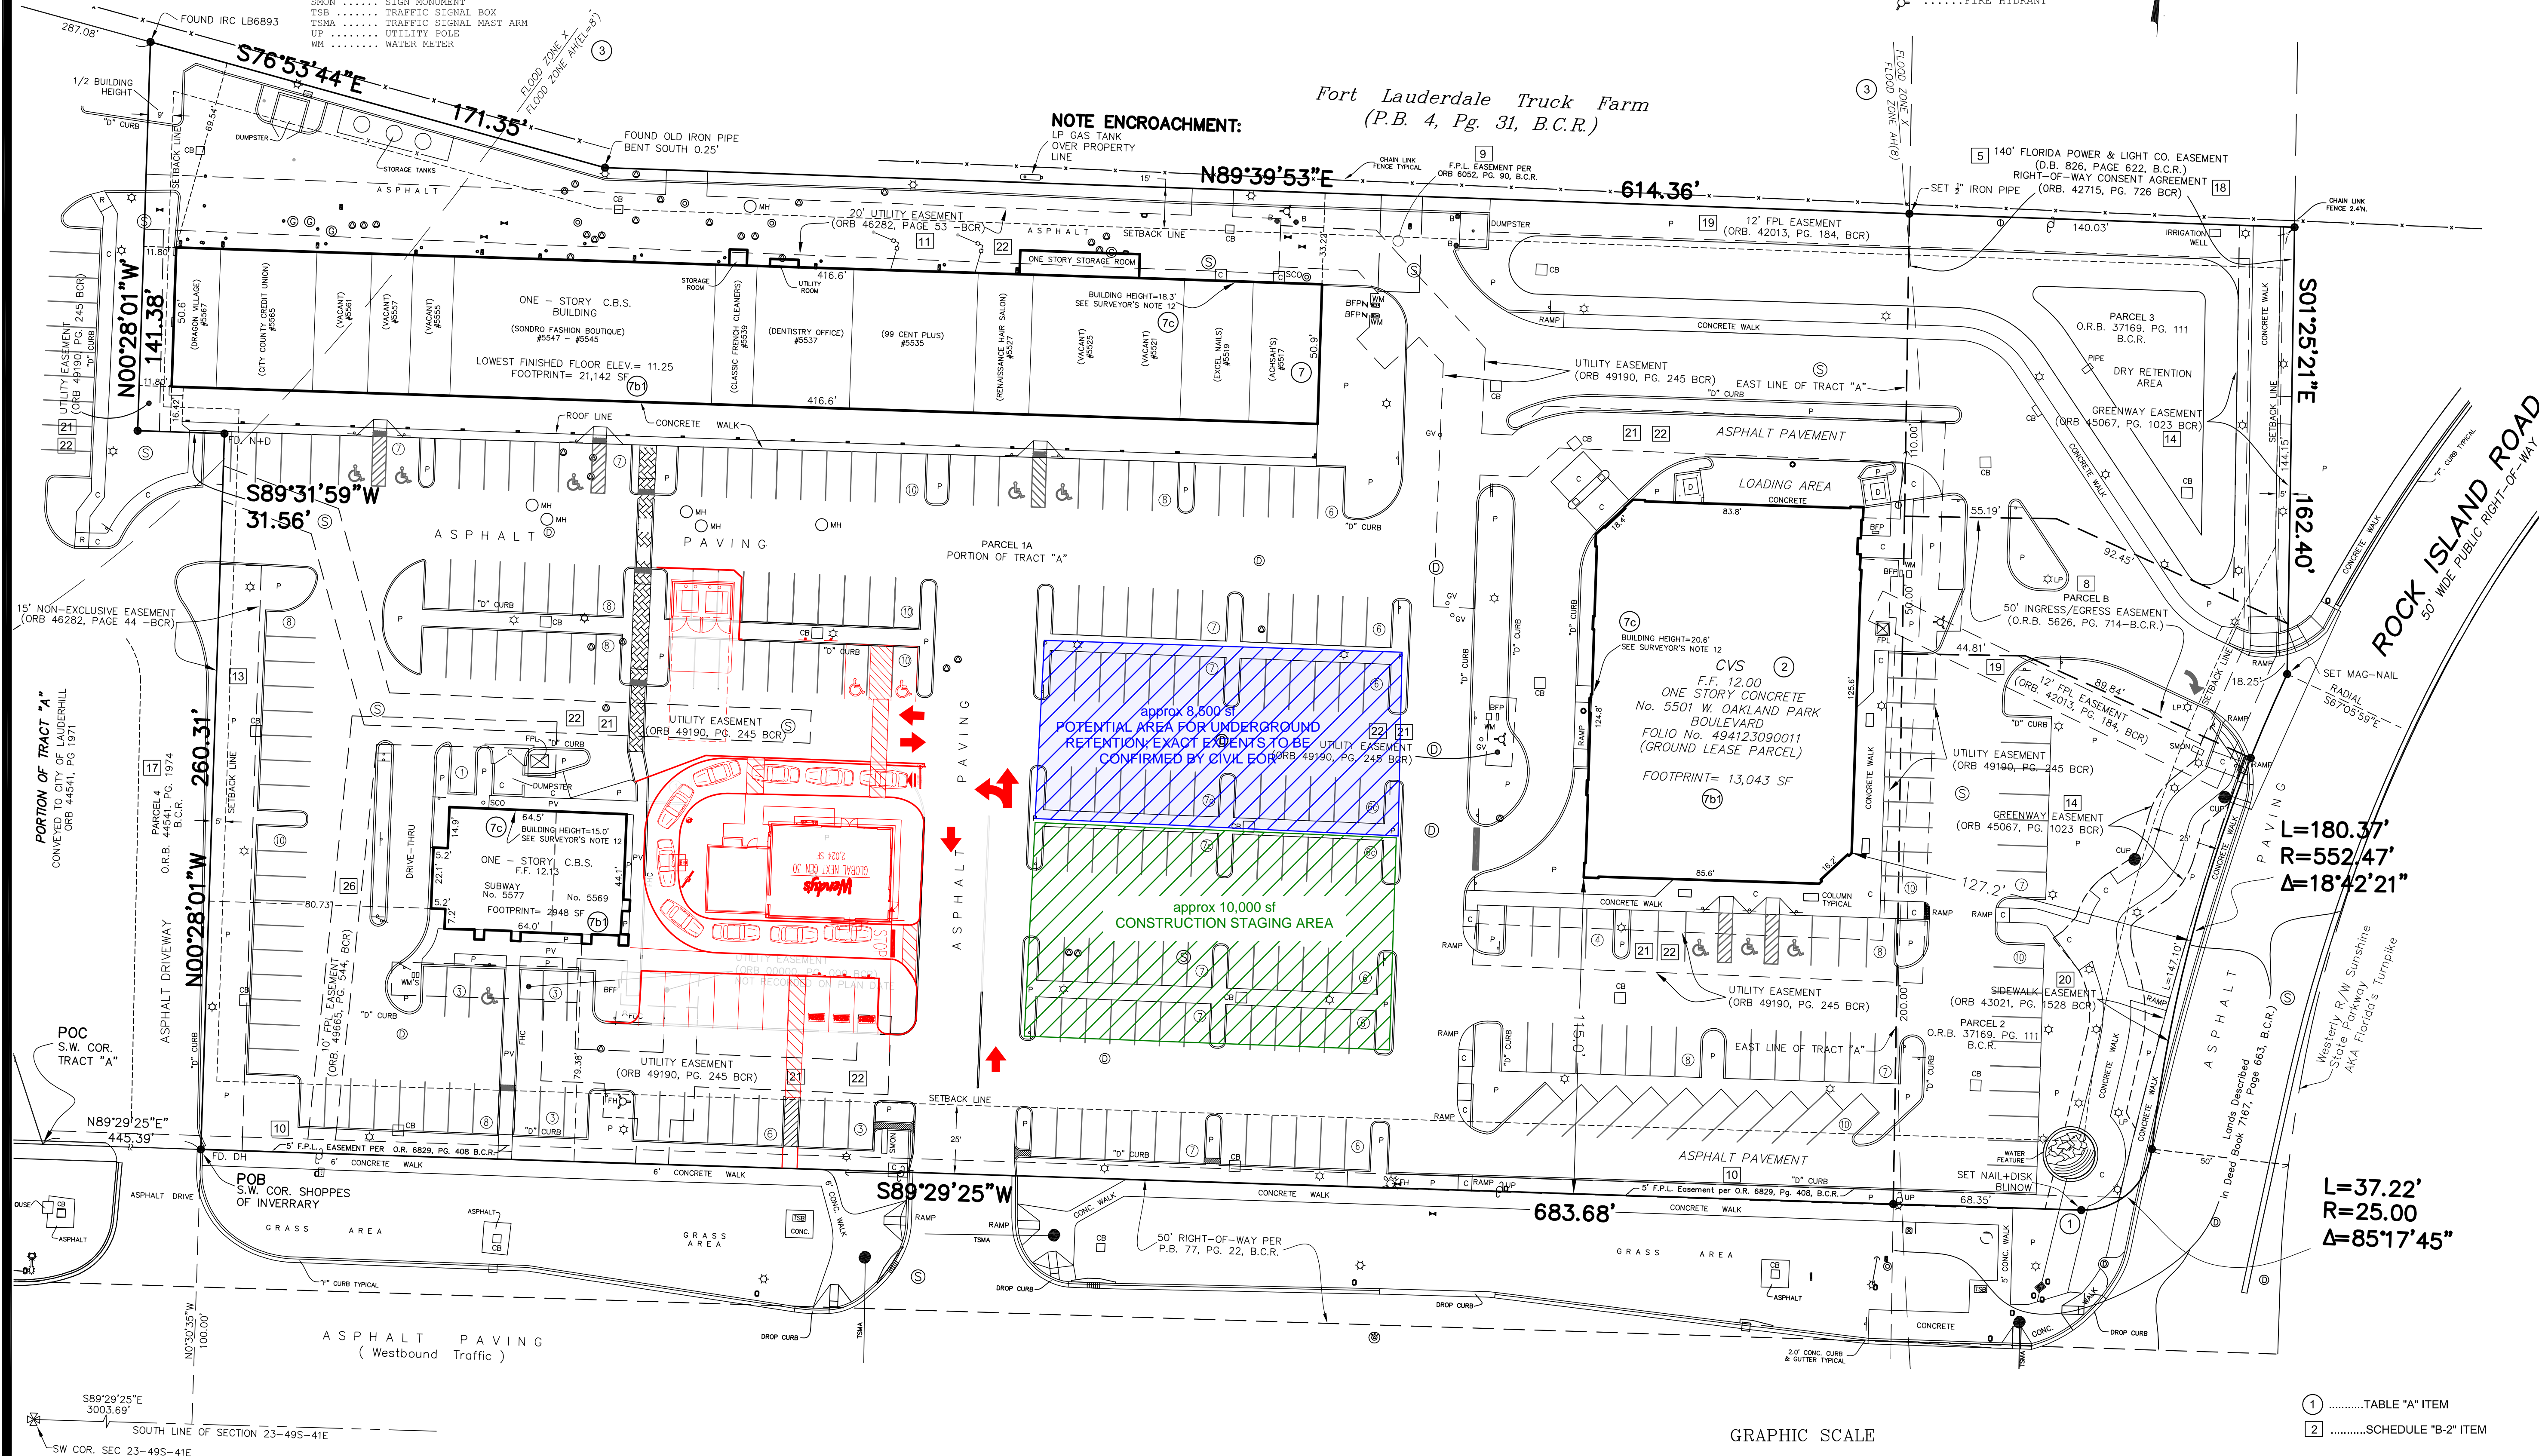

PROPERTY ADDRESSES:

SHOPPES OF INVERRARY: 5517-5567 W.OAKLAND PARK BLVD., LAUDERHILL, FL 33313
CVS: 5501 W. OAKLAND PARK BLVD., LAUDERHILL, FL 33313
SUBWAY OUTPARCEL: 5569-5577 W. OAKLAND PARK BLVD., LAUDERHILL, FL 33313